2004 o r NUL-

Inventor: Shiuh-Yuan Chen 09/882,766

Application No.:

Office Action Dated 04/07/04 Reply to

Attorney Docket: 16869B-024900US

Replacement Sheet Fig. 2A

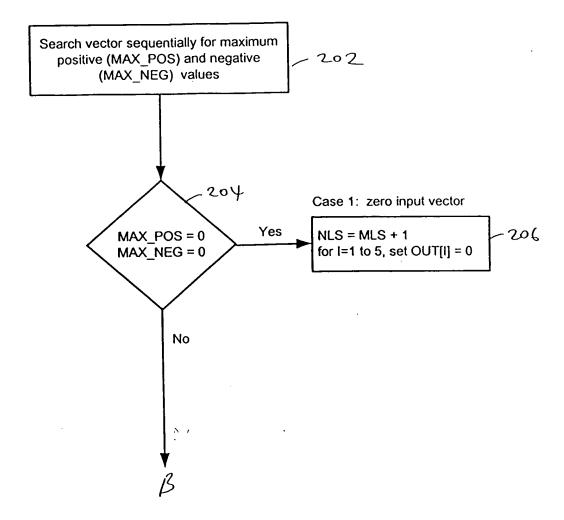


FIG. 2A


JUN 1 0 2004

Inventor: Shiuh-Yuan Chen

Application No.: 09/882,766


Reply to Office Action Dated 04/07/04

Attorney Docket: 16869B-024900US Replacement Sheet for Fig. 2B

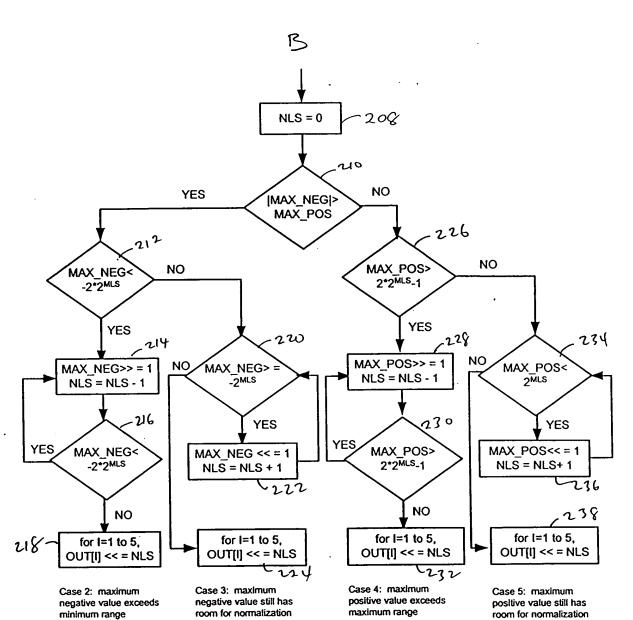

F16. 23

Inventor: Shiuh-Yuan Chen
Application No.: 09/882,766
Reply to Office Action Dated 04/07/04
Attorney Docket: 16869B-024900US
Red line Copy Showing Changes Fig 2A

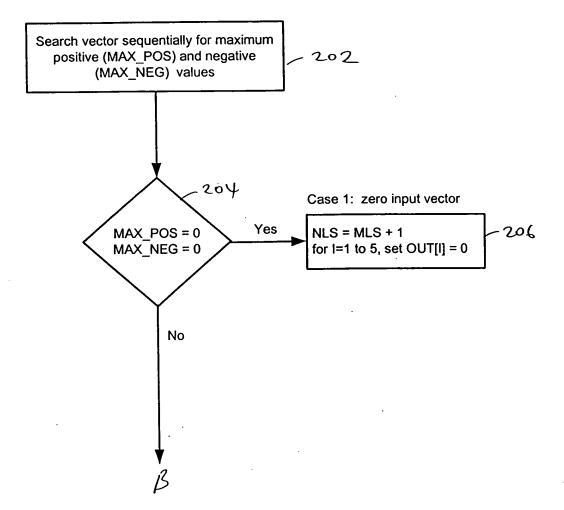


F1G. ZA

JUN 1 0 2004 EST

Inventor: Shiuh-Yuan Chen Application No.: 09/882,766

Application No.: 09/882,766
Reply to Office Action Dated 04/07/04

Attorney Docket: 16869B-024900US Red line Copy Showing Changes Fig 2B

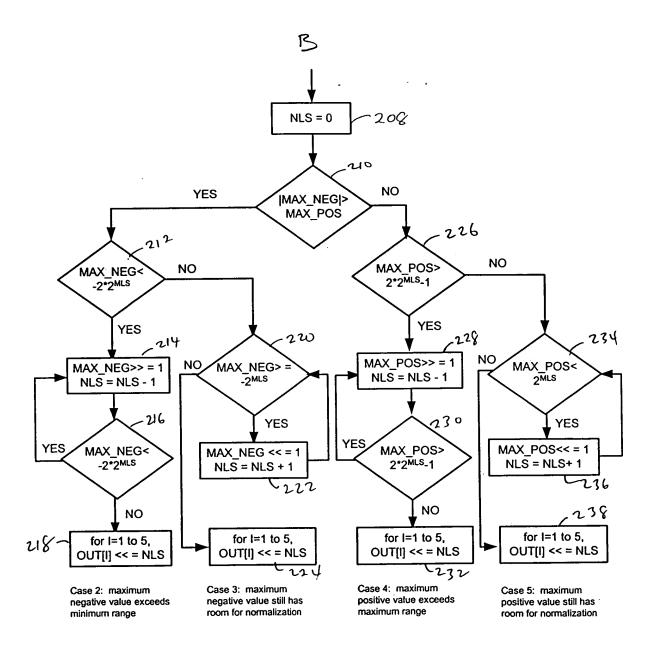

F1G, 2B